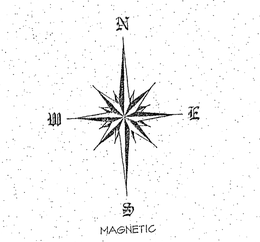

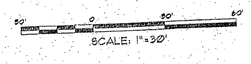

* Please note: The proposed addition was hand drawn on the survey plan and is not to scale.

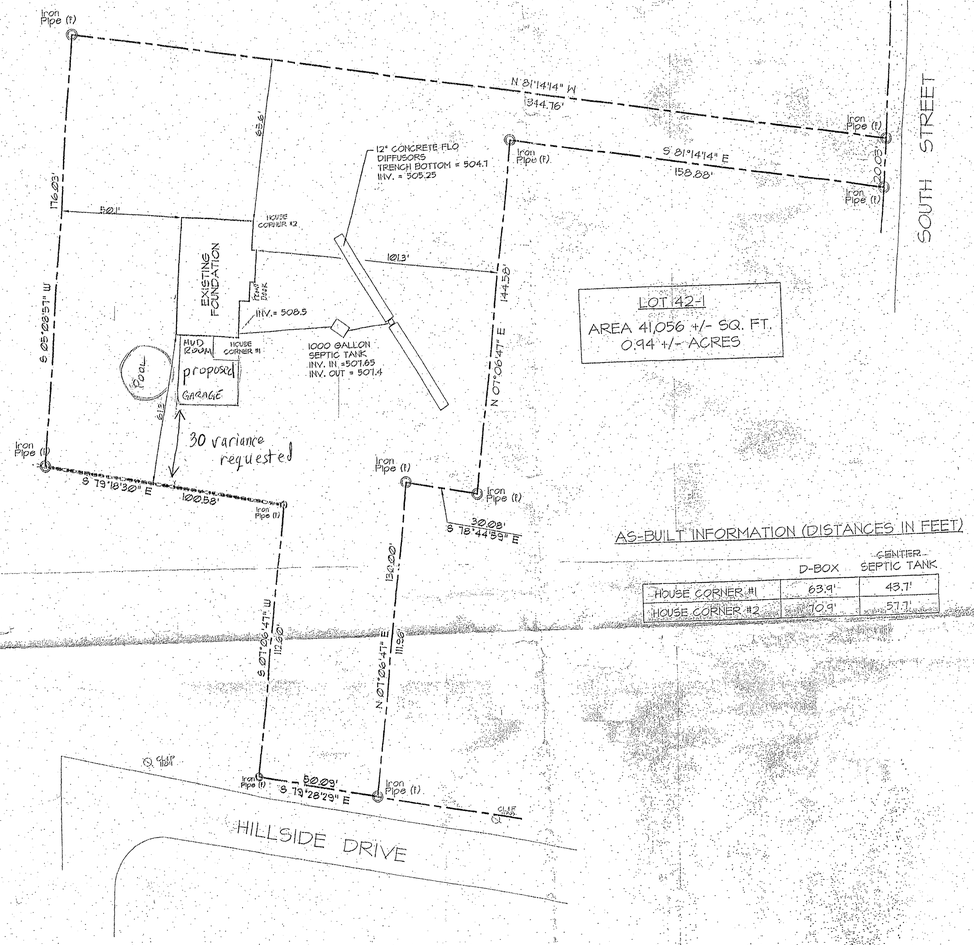

AS-BUILT INFORMATION (DISTANCES IN FEET)

	D-BOX	CENTER SEPTIC TANK
HOUSE CORNER #1	63.9'	43.7'
HOUSE CORNER #2	110.9'	57.7'

LOT 42-1
AREA 41,056 +/- SQ. FT.
0.94 +/- ACRES

LEGEND

PROPERTY LINE
STONEWALL
TREELINE
BUILDABLE AREA:
IRON PIPE
PROPERTY POINT
UTILITY POLE
TEST HOLE

ARCHER

GENERAL NOTES:

1. THIS SURVEY AND MAP HAS BEEN PREPARED IN ACCORDANCE WITH REGULATIONS OF CONNECTICUT STATE AGENCIES SECTIONS 20-300B-1 THROUGH 20-300B-20 AND THE STANDARDS FOR SURVEY AND MAPS IN THE STATE OF CONNECTICUT AS ADOPTED BY THE CONNECTICUT ASSOCIATION OF LAND SURVEYORS, INC. ON SEPTEMBER 26, 1996.
   A) TYPE OF SURVEY: ZONING LOCATION SURVEY
   B) HORIZONTAL ACCURAY: A-2
   C) INTENT: AS-BUILT
2. THIS MAP DEPICTS A ZONING LOCATION SURVEY OF LOT 42-1, OF MAP 46 OF THE BROOKLYN ASSESSORS OFFICE.
3. FIELD VERIFATION HAS DONE IN FEBRUARY 12, 2007.
4. SURVEY IS VALID ONLY IF PRINT HAS ORIGINAL SEAL AND SIGNATURE OF THE SURVEYOR.
5. PROPERTY IS ZONED RA30.
6. PROPOSED HOUSE TO BE SERVICED BY CITY WATER.

GENERAL NOTES:

1. SUBDIVISION MAP, HILL SIDE DRIVE, PREPARED FOR TRAP ROCK LLC, DATED AUGUST 2006, SCALE 1"=30', PREPARED BY ARCHER SURVEYING, LLC

TO MY KNOWLEDGE AND BELIEF THIS MAP IS SUBSTANTIALLY CORRECT AS NOTED HEREON

PAUL M. ARCHER LLS — DATE 4/30/07

STATE OF CONNECTICUT — PAUL M. ARCHER — 10078 — LICENSED LAND SURVEYOR

ARCHER Surveying L.L.C.
138 Day Street Brooklyn, Ct
(860) 779-2240

ZONING LOCATION SURVEY

Prepared for
TRAP ROCK LLC

SOUTH STREET / HILLSIDE DRIVE
BROOKLYN, CONNECTICUT

Pro
A
Sur
Dat
F
She

RECEIVED
APR 2 8 2021